

ZONE 1


ZONE 3

ZONE 2

ZONE 4

Bldg 2

1 OVERALL ARCHITECTURAL FLOOR PLAN
A101 SCALE: 1/16"=1'-0"

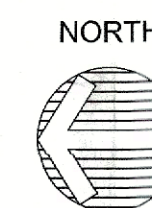

REVISIONS

LAKE TECH CLASSROOM REMODEL
EUSTIS CAMPUS - BLDG. 2

2001 KURT ST.
EUSTIS, FLORIDA, 32726

SCHEMATIC



1000 EAST HWY 50 SUITE 201A, CLEVENLY, FL 34711
PH: (407) 898-5677 FAX: (888) 658-4814
Web Site: www.gatorsketch.com

SIGN DATE

CONSTRUCTION DOCUMENTS

COPYRIGHT © 2005
GATORSKETCH CORP.
THIS DRAWING IS PROTECTED BY
COPYRIGHT LAWS OF THE
UNITED STATES. NO PART OF THIS
DESIGN OR THIS DOCUMENT,
INCLUDING ELECTRONIC MEDIA,
MAY BE REPRODUCED,
TRANSMITTED, COPIED OR
OTHERWISE USED FOR
CONSTRUCTION PURPOSES
WITHOUT EXPRESSED WRITTEN
PERMISSION OF THE DESIGN
PROFESSIONAL. VIOLATORS WILL
BE SUBJECT TO LEGAL
PROSECUTION TO THE FULLEST
EXTENT OF THE LAW.

ARCHITECTURAL
SITE PLAN/ ROOF

PLAN

A101

ISSUE DATE 5-30-25

JOB #: GC-25-016