



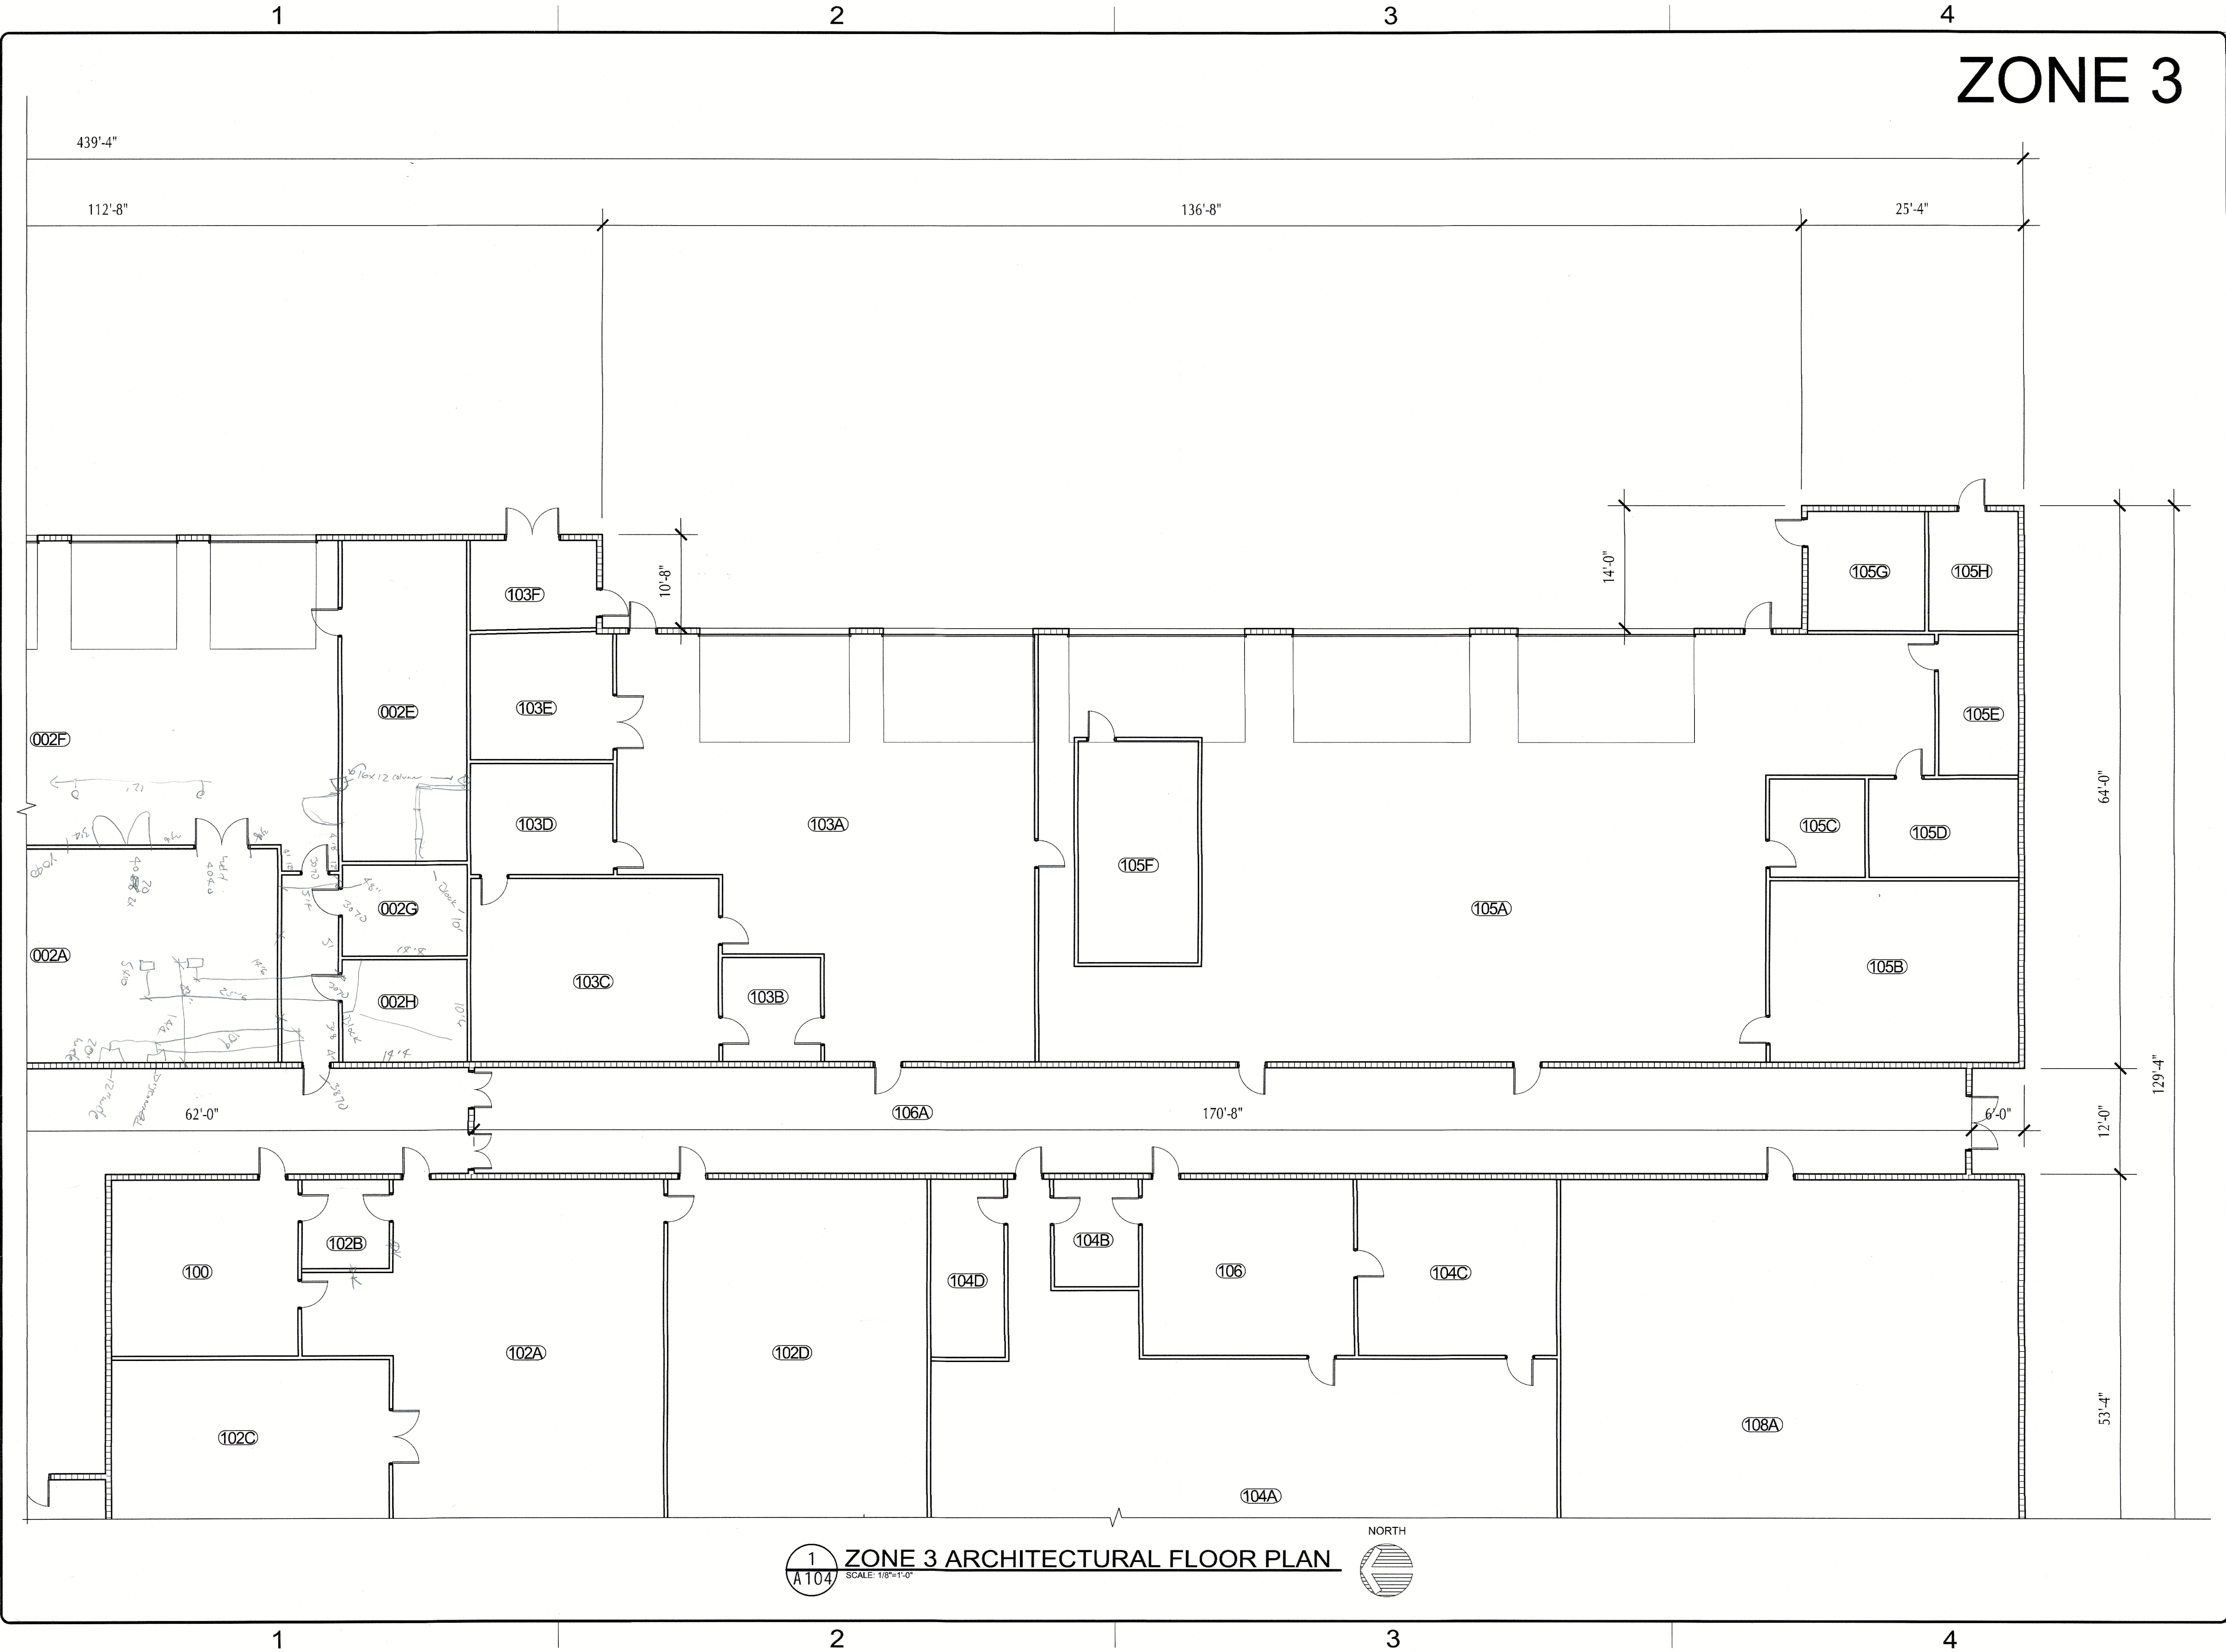

1
A104
SCALE: 1/8"=1'-0"

ZONE 3 ARCHITECTURAL FLOOR PLAN

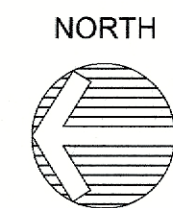

SIGNATURE	DATE	CONSTRUCTION DOCUMENTS COPYRIGHT © 2025 GATORSKETCH CORP. THIS DRAWING IS PROTECTED BY COPYRIGHT LAWS OF THE UNITED STATES. NO PART OF THIS DESIGN OR THIS DOCUMENT, INCLUDING ELECTRONIC MEDIA, MAY BE REPRODUCED, TRANSMITTED, COPIED OR OTHERWISE USED FOR CONSTRUCTION PURPOSES WITHOUT EXPRESSED WRITTEN PERMISSION OF THE DESIGN PROFESSIONAL. VIOLATORS WILL BE SUBJECT TO LEGAL PROSECUTION TO THE FULLEST EXTENT OF THE LAW.	A	JOB # GC-25-016	ISSUE DATE 5-30-25	A104 FLOOR PLAN	ZONE 3 ARCHITECTURAL	GatorSketch ARCHITECTS & PLANNERS AG03032010 1000 EAST HWY 50 SUITE 207A, CLEMONT, FL 34711 PH: (407) 908-5877 FAX: (888) 958-4814 Web Site: www.gatorsketch.com	SCHEMATIC	LAKE TECH CLASSROOM REMODEL EUSTIS CAMPUS - BLDG. 2 2001 KURT ST. EUSTIS, FLORIDA, 32726	REVISIONS