


1


ZONE 1

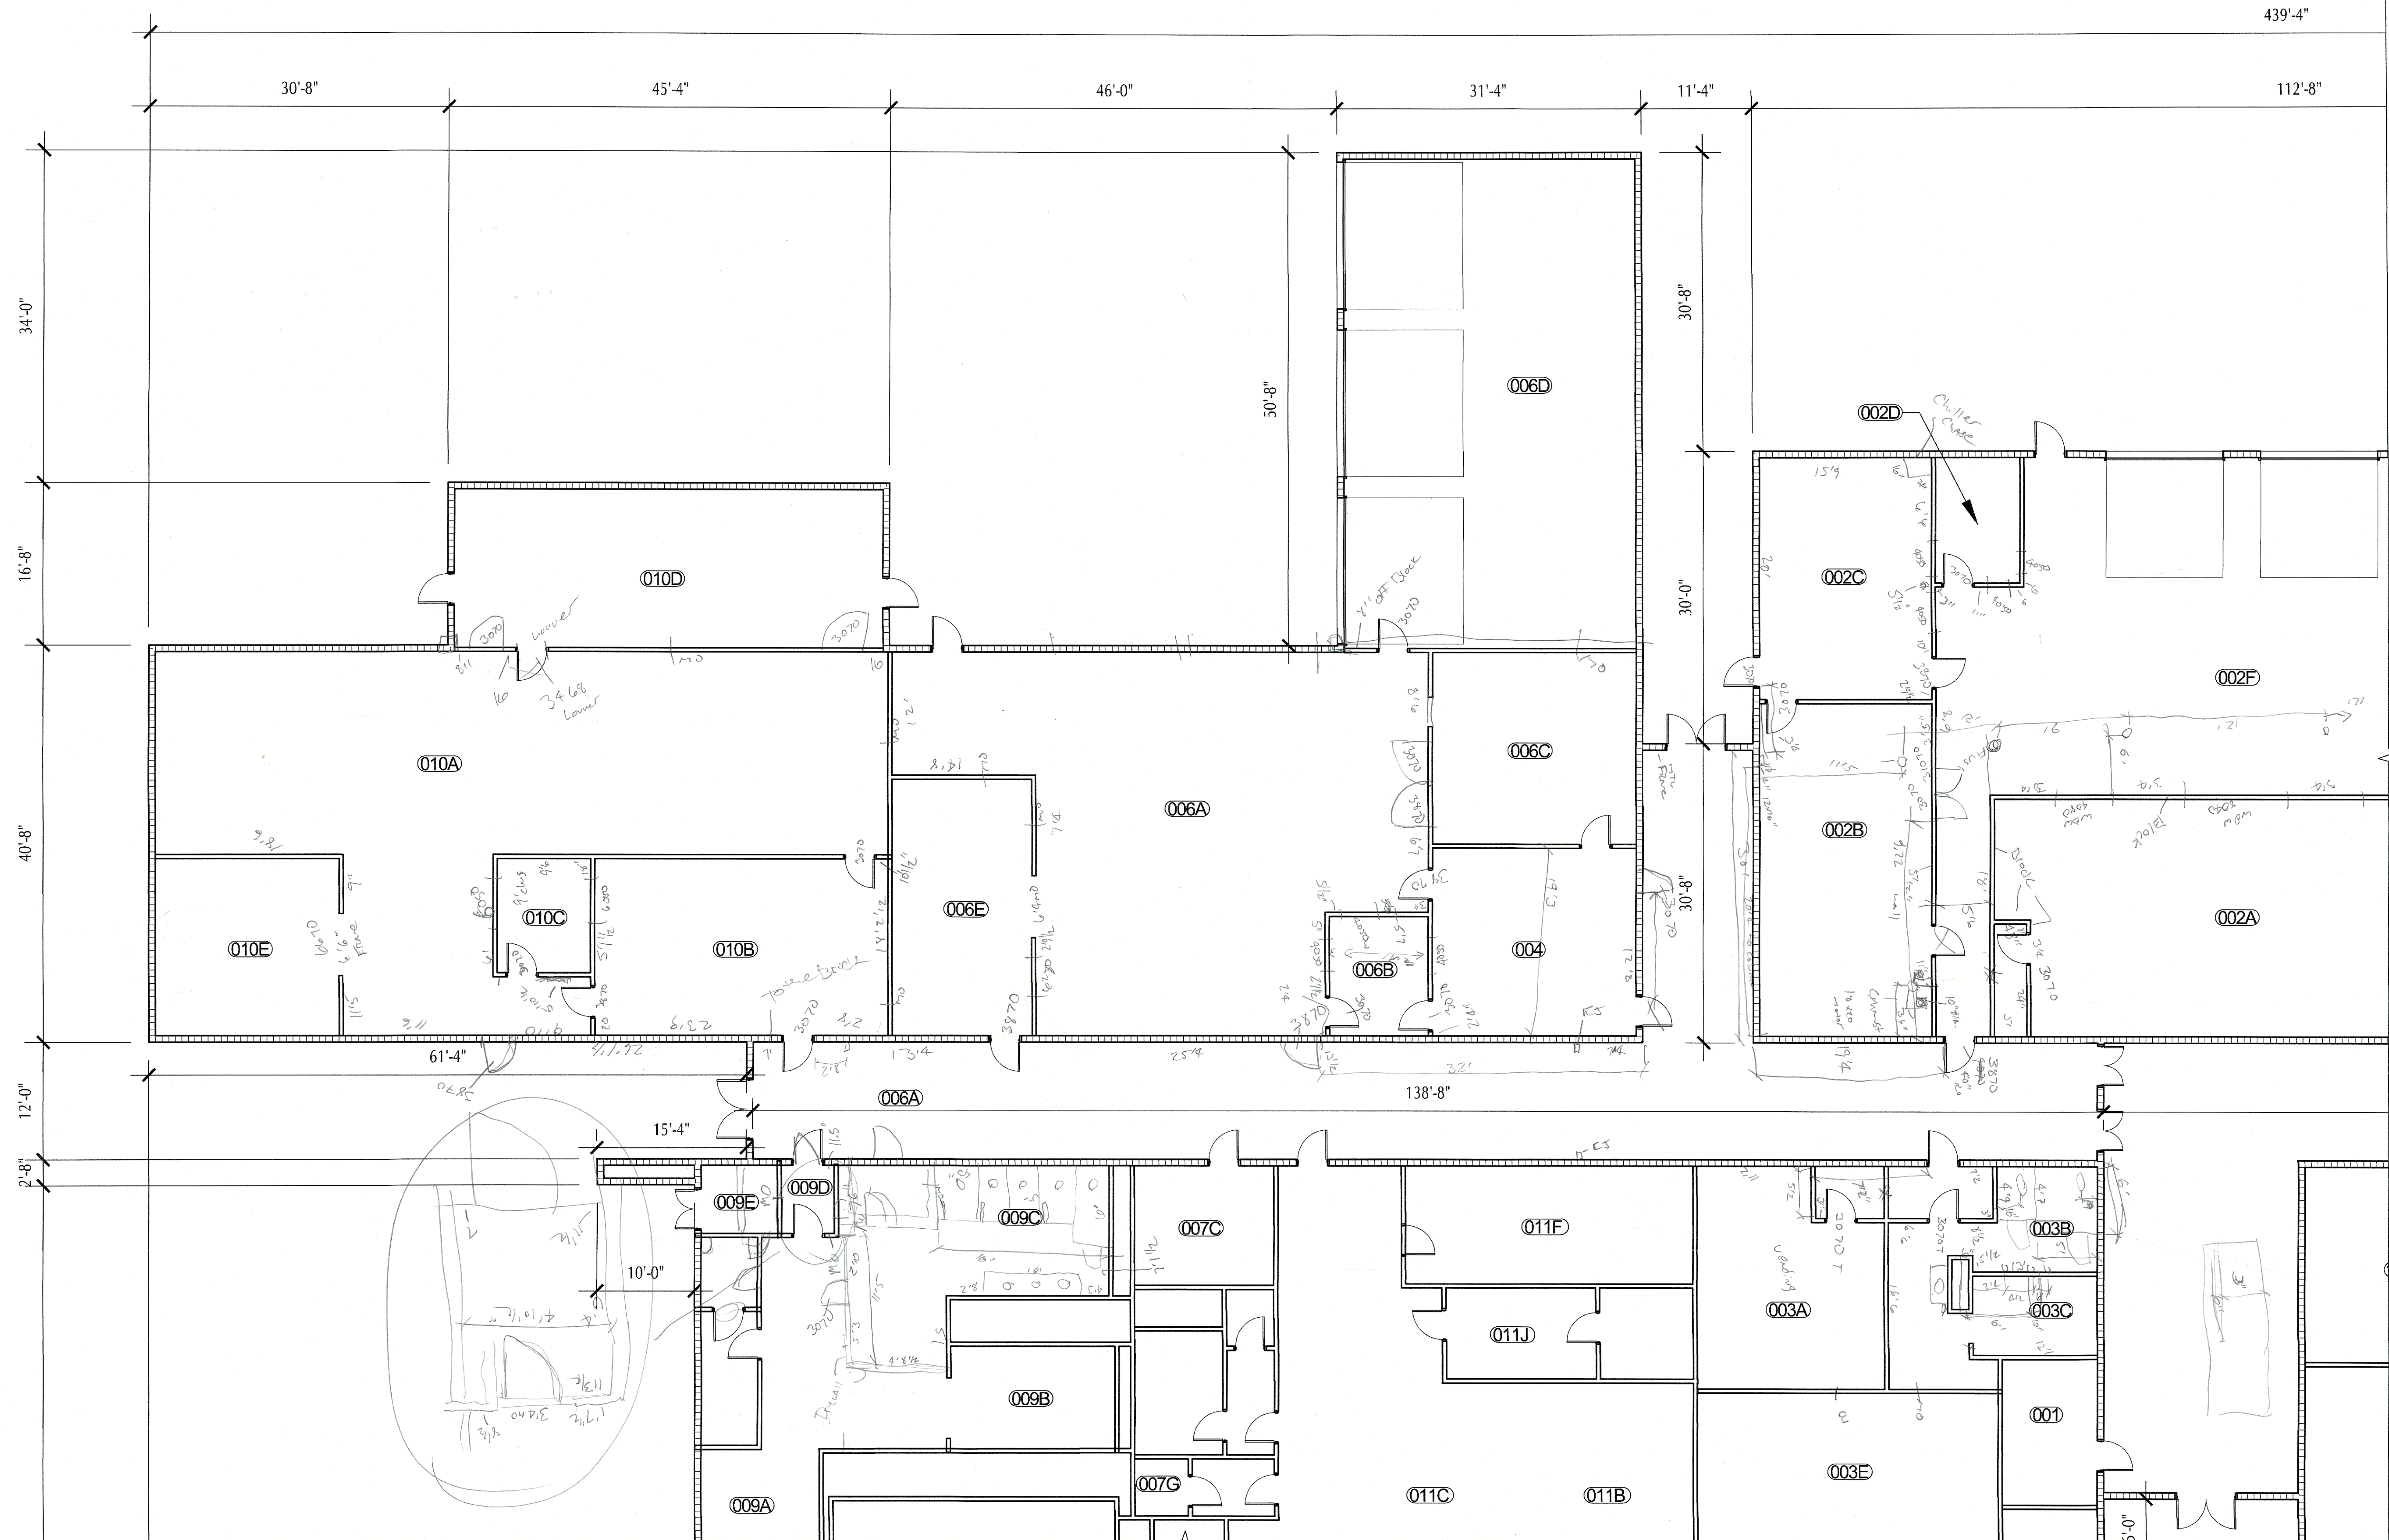

1
A102

ZONE 1 ARCHITECTURAL FLOOR PLAN

SCALE: 1/8"=1'-0"

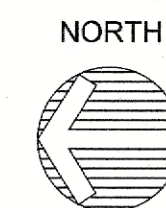

REVISIONS

**LAKE TECH CLASSROOM REMODEL
EUSTIS CAMPUS - BLDG. 2**

**2001 KURT ST.
EUSTIS, FLORIDA, 32726**

SCHEMATIC

GatorSketch
ARCHITECTS & PLANNERS

AZ0002310

1000 EAST HWY 50 SUITE 201A, CLERMONT, FL 34711

PH: (407)608-5677 FAX: (888)559-4814

Web Site: www.gatorsketch.com

**CONSTRUCTION
DOCUMENTS**

**COPYRIGHT © 2025
TORSKOTCH CORP.**

**THIS DRAWING IS PROTECTED BY
COPYRIGHT LAWS OF THE
UNITED STATES. NO PART OF THIS
DESIGN OR THIS DOCUMENT,
INCLUDING ELECTRONIC MEDIA,
MAY BE REPRODUCED,
UNSCRIBED, COPIED, OR
SERVISE USED FOR
CONSTRUCTION PURPOSES
WITHOUT EXPRESSED WRITTEN
PERMISSION OF THE DESIGN
PROFESSIONAL. VIOLATORS WILL
BE SUBJECT TO LEGAL
PUNISHMENT TO THE FULLEST
EXTENT OF THE LAW**

ZONE 1
ARCHITECTURAL
FLOOR PLAN
A102
ISSUE DATE 5-30-25
JOB #: GC-25-016